


AS-BUILT

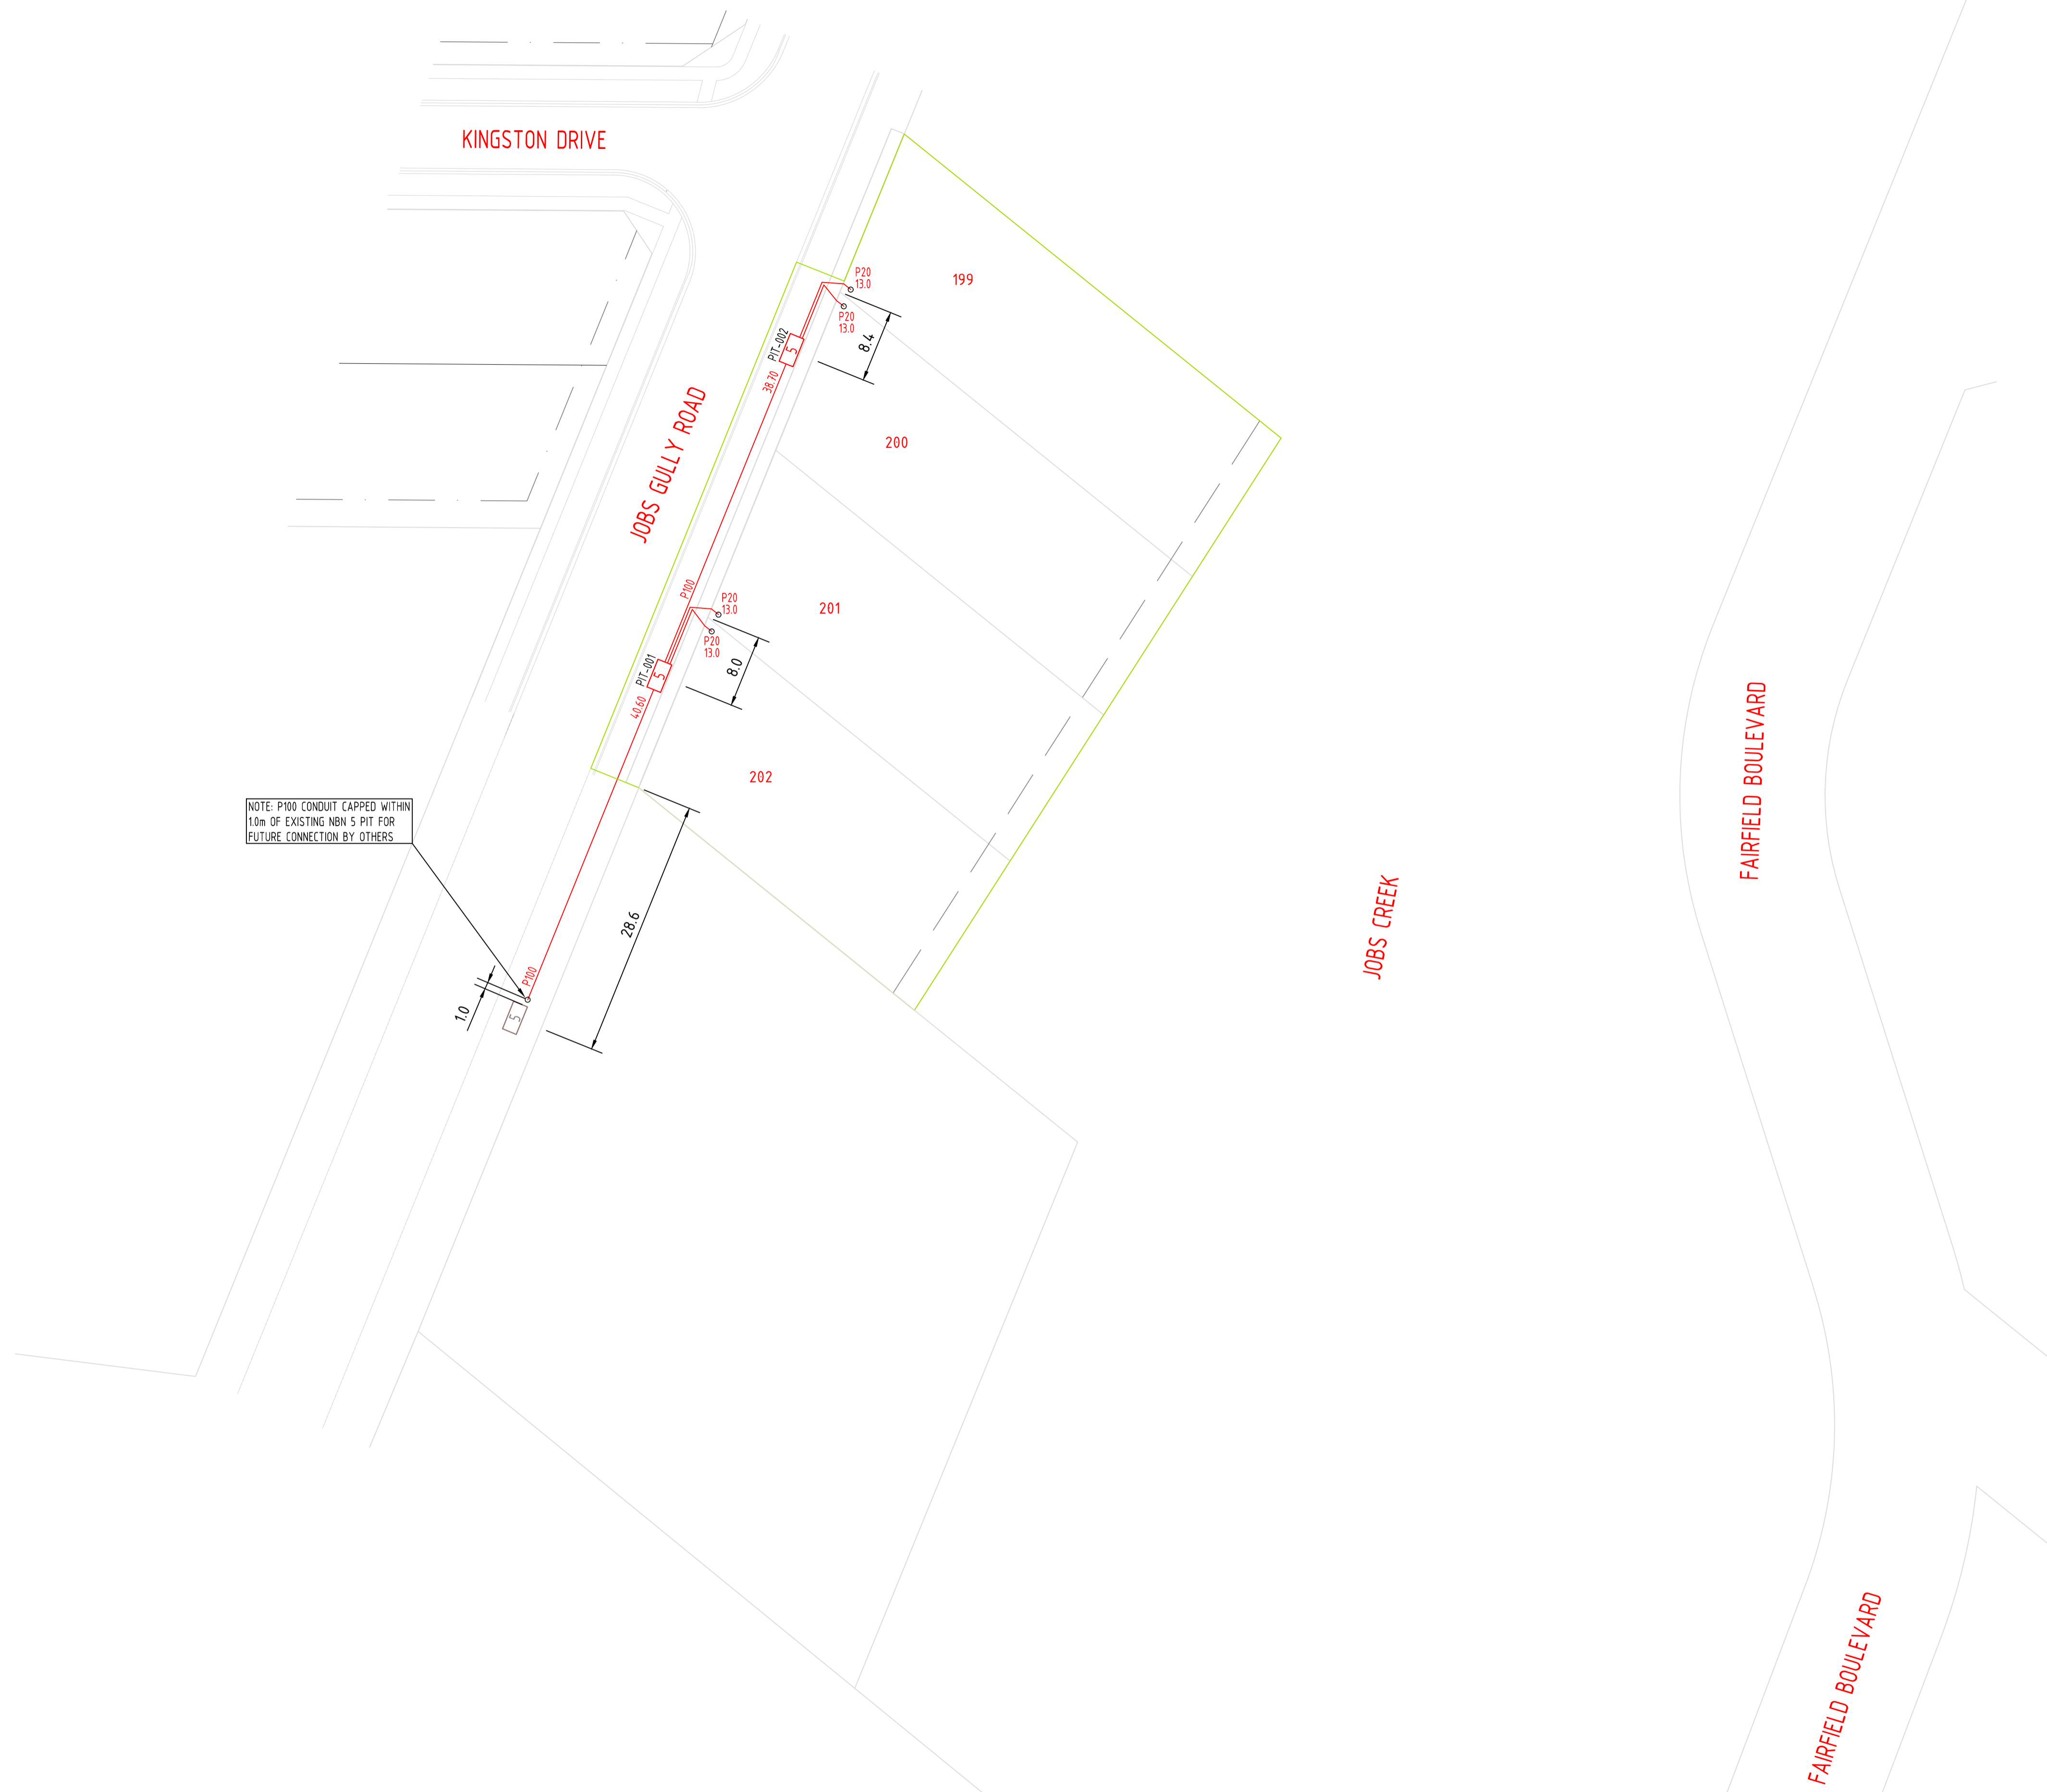

NOTE: P100 CONDUIT CAPPED WITHIN 10m OF EXISTING NBN 5 PIT FOR FUTURE CONNECTION BY OTHERS

PIT LEGEND	
Shared Trench Symbol	
PIT-ID 2	Service Drop Access Pit 650mm(L) x 280mm(W) x 565mm(D)
PIT-ID 5	Network Boundary/Local Network Pit 700mm(L) x 450mm(W) x 650mm(D)
PIT-ID 6	Distribution/Local Network Connection Pit 1360mm(L) x 555mm(W) x 650mm(D)
PIT-ID 8	Distribution/Local Network Connection Pit 1360mm(L) x 555mm(W) x 860mm(D)
PIT-ID 9	Fibre Distribution Hub Pit 2000mm(L) x 555mm(W) x 900mm(D)

PIT LIDS TO BE LABELLED "NBN".

CONSTRUCTOR IS TO ENSURE PITS ARE INSTALLED IN NON-TRAFFICABLE AREAS, AT LEAST 15m AWAY FROM EPR ZONES AND CLEAR OF OTHER AUTHORITY EASEMENTS.

SERVICES CLEARANCES	
SERVICES ITEM	MINIMUM RADIAL CLEARANCES
GAS - LARGE MAIN (OVER 110mm DIA.) SMALL MAIN (110mm DIA. OR LESS)	300mm 150mm
ELECTRICAL - HIGH VOLTAGE LOW VOLTAGE	300mm 100mm*2
WATER - HIGH CAPACITY MAIN LOCAL RETICULATION	300mm 150mm
SEWER - MAIN CONNECTION PIPE	300mm 150mm
OTHER TELECOMMUNICATIONS	100mm*
DRAINAGE - MAIN CONNECTION PIPE	300mm 150mm

* 1 - REDUCED SEPARATION IS POSSIBLE WHERE ALL PARTIES ARE CONSULTED AND AGREEMENT IS REACHED
* 2 - ONLY WHERE PROTECTION BARRIERS ARE USED, FOR EXAMPLE, CONDUIT, BEEDING, MARKER TAPE & COVER BATTEN

PCD / NTD LOCATIONS
P20 LEAD-IN LOCATIONS ARE INDICATIVE ONLY, AND ARE TO BE CONFIRMED AT TIME OF CONSTRUCTION.
FOR LOCATION REQUIREMENTS REFER TO NBN DOCUMENT: NBN-DES-STD-0011
RESIDENTIAL PREPARATION AND INSTALLATION SINGLE DWELLING UNITS (SDUs) AND MULTI DWELLING UNITS (MDUs)
ISSUE DATE: 12 DEC 2016 REVISION NO. 11.0

DESIGN & INSTALLATION SPECIFICATIONS
THIS DESIGN IS TO BE READ IN CONJUNCTION WITH NBN DOCUMENT: NBN-TE-CTO-194
"NEW DEVELOPMENTS: DEPLOYMENT OF THE NBN PIT AND CONDUIT NETWORK"
ISSUE DATE: 08/12/2017, REVISION: 8
ALL DEPLOYMENT WORKS TO BE COMPLETED TO NBN SPECIFICATIONS AS OUTLINED IN THE ABOVE DOCUMENT

SDU Development Information	
Development Name:	CANTERBURY PARK ESTATE
Developer Company:	ARBOR ESTATES PTY LTD
Development Address:	JOBS GULLY ROAD, BENDIGO, VIC
Authorised Rep:	RURIK DAWBORN
Phone:	(03) 5442 5799
E-Mail:	rdawborn@terraco.com.au
nbn Reference Number:	AYCA-25NHVK
Stage Number:	8
Design Revision:	C

BILL OF MATERIAL				
NO OF LOTS: 4				
PITS		DUCTS		
SIZE	QTY	SIZE	QTY	MTRS
2	0	P100	2	79.3
5	2	P50	0	0.0
6	0	P20	4	52.0
8	0			
9	0			

TOTAL NUMBER OF PITS: 2
TOTAL NUMBER OF MANHOLES: 0
TOTAL NUMBER OF CONDUITS: 6
TOTAL LENGTH OF CONDUITS: 131.3



REV	DATE	DRAFTER	DESCRIPTION	APPROVED
C	22.05.2019	KT (G3NS)	AS-BUILT DETAILS ADDED	SM (G3NS)
B	15.04.2019	SM (G3NS)	DESIGN REVIEW COMPLETED BY NBN, DRAWING ISSUED FOR CONSTRUCTION	GJ (G3NS)
A	10.04.2019	KT (G3NS)	INITIAL DESIGN OF INTENT	SM (G3NS)

STRICTLY CONFIDENTIAL


NBNCO APPROVAL RECORD:

SIGNATURE: _____ DATE: _____

DD _____
WD _____
AB _____

QUALITY RECORD:

NBNCO DISCLAIMER
THIS DOCUMENT HAS BEEN PREPARED SOLELY FOR THE USE OF NBNCO LIMITED (ABN 86 136 533 741) FOR USE IN MAINTAINING NBNCO FACILITIES. IT HAS NOT BEEN CREATED FOR ANY OTHER USE. IT SHOULD NOT BE SCALED TO LOCATE NBNCO ASSETS. NO WARRANTY IS GIVEN THAT THE INFORMATION IS ACCURATE OR COMPLETE.

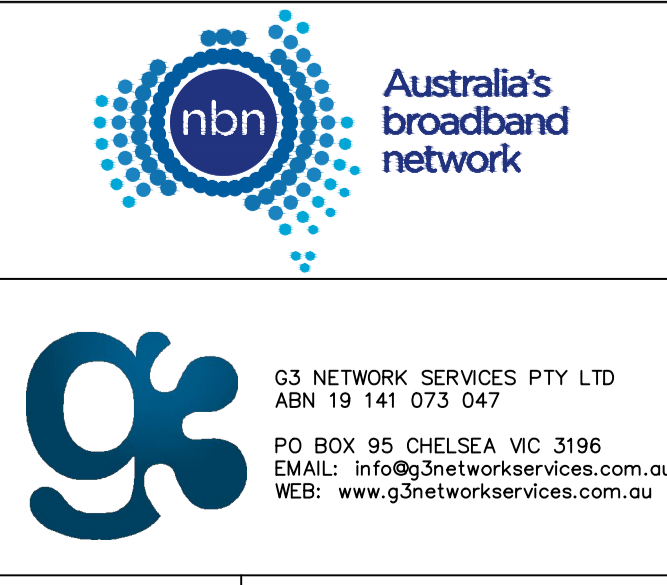

KEY PLAN

STATE:	VIC	REGION:	
FSA:		SAM:	
PROJECT No:	AYCA-25NHVK		
CADREF No:	G3NS2647		
SCALE	N/A	SHEET No.	1 OF 1
REV.			C

DRAWING TITLE:	
NBN PIT & PIPE AS-BUILT	
CANTERBURY PARK ESTATE STAGE 8	
JACKASS FLAT	
4 LOTS	
ENABLE#:	277108
STATE:	VIC
REGION:	
FSA:	
SAM:	
ADA:	
PROJECT No:	AYCA-25NHVK
CADREF No:	G3NS2647
SCALE	N/A
SHEET No.	1 OF 1
REV.	C