

PROJECT LEGEND

	PIT-ID 2 Service Drop Access Pit (650mmX280mmX565mm)
	PIT-ID 5 Network Boundary/Local Network Pit (Single Lid) (700mmX450mmX650mm)
	PIT-ID 6 Distribution/Local Network Connection Pit (Dual Lid) (1360mmX555mmX650mm)
	PIT-ID 8 Distribution/Local Network Connection Pit (1360mmX555mmX860mm)
	PIT-ID 9 Fibre Distribution Hub (FDH) Pit (2000mmX555mmX900mm)
	PWR Transformer / Kiosk / Pad Mount Sub-station / Pole Mount Transformer
	Existing Telstra Pit (2,3,4,5,6,7,8,9)

SDU Development Information

Development Name: 178-182 Murphy Street, East Bendigo	
Developer Company: Arbor Estates Pty Ltd	
Development Address: 178-182 Murphy Street, East Bendigo	
Authorised Rep: Thomas Davies Phone: 0432948731 E-Mail: tdavies@terraco.com.au	
nbn Reference Number: STG-W000226335	Stage Number: 1 Design Revision: 0

BILL OF MATERIAL

NO OF LOTS: 20

PITS		DUCTS	
SIZE	QTY	SIZE	QTY
2	0	P100	8
5	13	P50	25
6	0	P20	0
8	0		
9	0		

TOTAL NUMBER OF PITS: 13
TOTAL NUMBER OF MANHOLES: 0
TOTAL NUMBER OF CONDUITS: 33
TOTAL LENGTH OF CONDUITS: 729.9

WARNING

BEWARE OF UNDERGROUND SERVICES
THE LOCATION OF UNDERGROUND SERVICES ARE APPROXIMATE ONLY AND THEIR EXACT POSITION SHOULD BE PROVEN ON SITE. NO GUARANTEE IS GIVEN THAT ALL EXISTING SERVICES ARE SHOWN.



REV	DATE	DRAFTER	DESCRIPTION	APPROVED
-				
E	14/04/2023	T.D (TERRACO)	AS BUILT	J.S (TERRACO)
D	04/08/2022	T.D (TERRACO)	PIT-001 UPGRADED	J.S (TERRACO)
C	23/05/2022	T.D (TERRACO)	CONSTRUCTION ISSUE	J.S (TERRACO)
B	06/04/2022	T.D (TERRACO)	REVISED BOM	J.S (TERRACO)
A	29/03/2022	T.D (TERRACO)	ORIGINAL ISSUE	J.S (TERRACO)


STRICTLY CONFIDENTIAL

NBNCO APPROVAL RECORD:

SIGNATURE	DATE
<input type="checkbox"/> DD	_____
<input type="checkbox"/> WD	_____
<input type="checkbox"/> AB	_____

QUALITY RECORD :

NBNCO DISCLAIMER
THIS DOCUMENT HAS BEEN PREPARED SOLELY FOR THE USE OF NBNCO LIMITED (ABN 86 136 533 741) FOR USE IN MAINTAINING NBNCO FACILITIES. IT HAS NOT BEEN CREATED FOR ANY OTHER USE. IT SHOULD NOT BE SCALED TO LOCATE NBNCO ASSETS. NO WARRANTY IS GIVEN THAT THE INFORMATION IS ACCURATE OR COMPLETE.

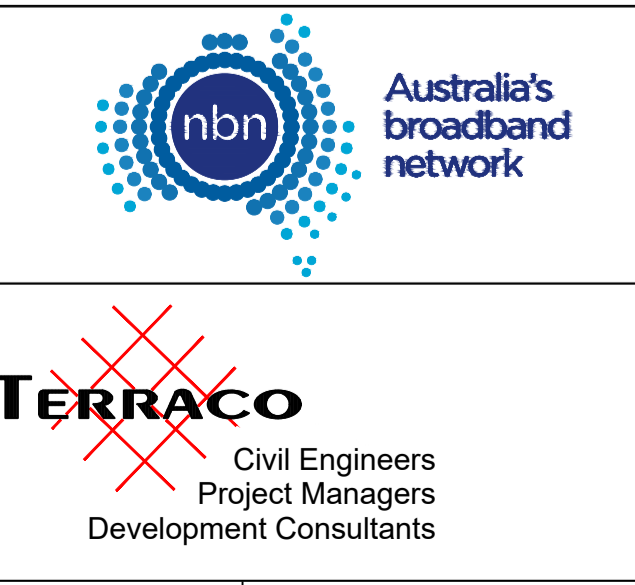

KEY PLAN

DRAWING TITLE:
NBN PIT & PIPE DESIGN
178-182 MURPHY STREET
EAST BENDIGO
20 LOTS

ENABLE#: 414213

STATE: VIC REGION:

PROJECT No:

CADREF No: 14042

SCALE: N/A SHEET No. 1 OF 1 REV. E