

PROJECT LEGEND

	PIT-ID 2 Service Drop Access Pit (650mmX280mmX565mm)
	PIT-ID 5 Network Boundary/Local Network Pit (Single Lid) (700mmX450mmX650mm)
	PIT-ID 6 Distribution/Local Network Connection Pit (Dual Lid) (1360mmX555mmX650mm)
	PIT-ID 8 Distribution/Local Network Connection Pit (1360mmX555mmX860mm)
	PIT-ID 9 Fibre Distribution Hub (FDH) Pit (2000mmX555mmX900mm)
	Transformer / Kiosk / Pad Mount Sub-station / Pole Mount Transformer
	Existing Telstra Pit (2,3,4,5,6,7,8,9)

SDU Development Information

Development Name: Hidden Court
 Developer Company: Agarius Pty Ltd
 Development Address: 169 Edwards Road, Kennington
 Authorised Rep: Tom Davies - Terraco
 Phone: 0432 948 731
 E-Mail: tdavies@terraco.com.au

nbn Reference Number: STG-W000197497
 Stage Number: 1 of 1
 Design Revision: C

BILL OF MATERIAL


NO OF LOTS: 10

PITS		DUCTS	
SIZE	QTY	SIZE	QTY MTRS
2	2	P100	4 390.9
5	4	P50	2 69.4
6	0	P20	10 143.3
8	0		
9	0		

TOTAL NUMBER OF PITS: 6
 TOTAL NUMBER OF MANHOLES: 0
 TOTAL NUMBER OF CONDUITS: 16
 TOTAL LENGTH OF CONDUITS: 601.6

WARNING

BEWARE OF UNDERGROUND SERVICES
 THE LOCATION OF UNDERGROUND SERVICES ARE APPROXIMATE ONLY AND THEIR EXACT POSITION SHOULD BE PROVEN ON SITE. NO GUARANTEE IS GIVEN THAT ALL EXISTING SERVICES ARE SHOWN.

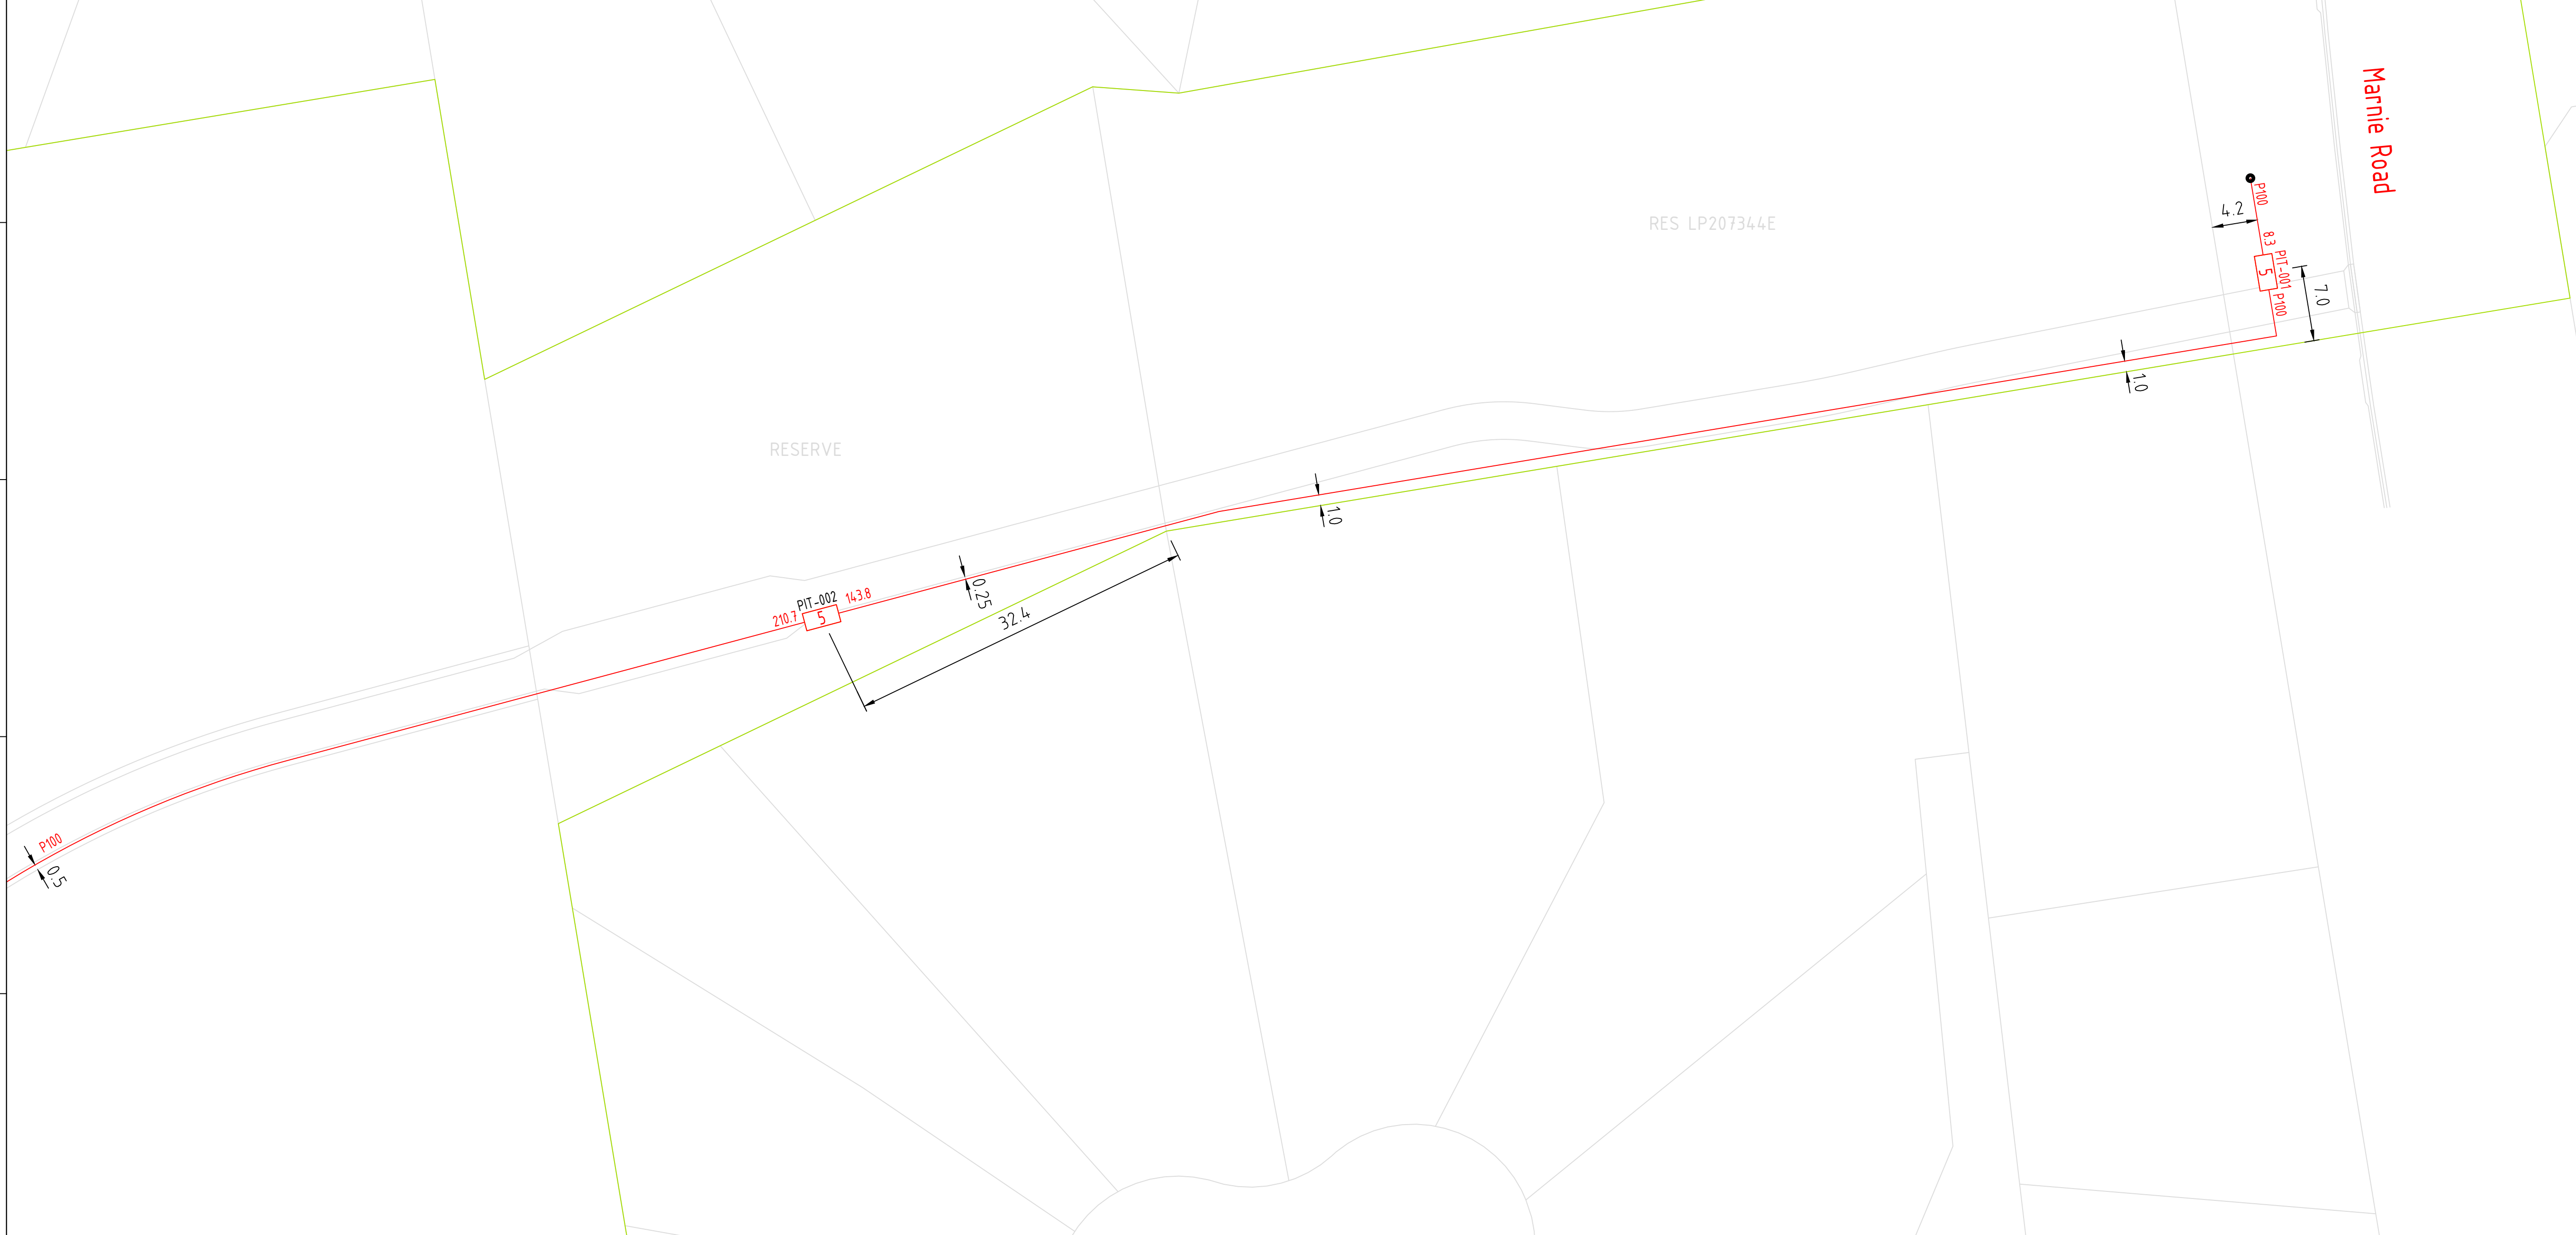

REV	DATE	DRAFTER	DESCRIPTION	APPROVED
C	06/10/2023	TD (TERRACO)	AS BUILT	AS (TERRACO)
B	19/06/2023	JS (TERRACO)	REVISED NBN OFFSET IN HIDDEN COURT	DR (TERRACO)
A	13/02/2023	JS (TERRACO)	INITIAL DESIGN	DR (TERRACO)

STRICTLY CONFIDENTIAL

NBNC APPROVAL RECORD:

	SIGNATURE	DATE
<input type="checkbox"/> DD	_____	_____
<input type="checkbox"/> WD	_____	_____
<input type="checkbox"/> AB	_____	_____

QUALITY RECORD:

NBNC DISCLAIMER
 THIS DOCUMENT HAS BEEN PREPARED SOLELY FOR THE USE OF NBNC LIMITED (ABN 86 136 533 741) FOR USE IN MAINTAINING NBNC FACILITIES. IT HAS NOT BEEN CREATED FOR ANY OTHER USE. IT SHOULD NOT BE SCALED TO LOCATE NBNC ASSETS. NO WARRANTY IS GIVEN THAT THE INFORMATION IS ACCURATE OR COMPLETE.

TERRACO
 Civil Engineers
 Project Managers
 Development Consultants

Terraco P/L
 ABN 12 681 695 776
 9 Jewell Court
 East Bendigo, Vic 3550
 Ph: 03 5442 5799
 Fax: 03 5441 5506
 E: info@terraco.com.au
 Web: www.terraco.com.au

KEY PLAN

DRAWING TITLE:
 NBN PIT & PIPE DESIGN
 HIDDEN COURT
 KENNINGTON
 10 LOTS

ENABLE#: 414213

STATE: VIC REGION:



FSA: SAM: ADA:

PROJECT No: STG-W000197497

CADREF No: 09075

SCALE: N/A SHEET No. 1 OF 2 REV. C



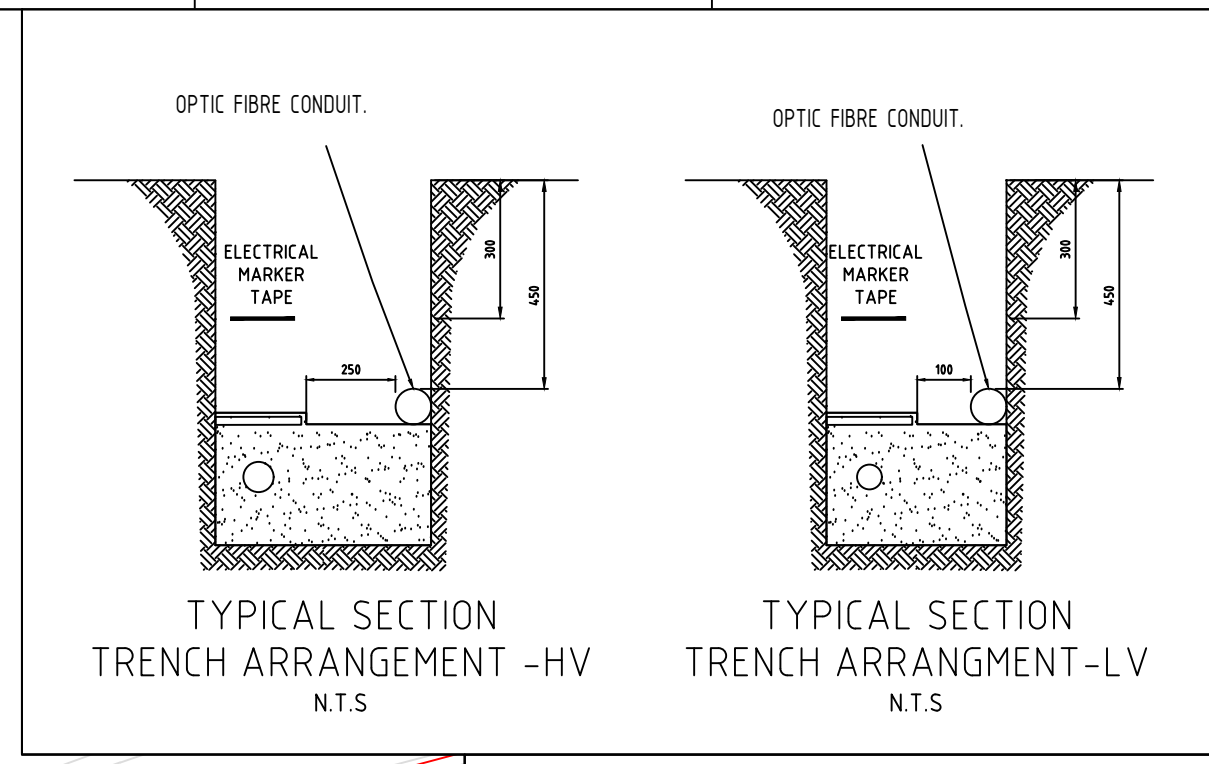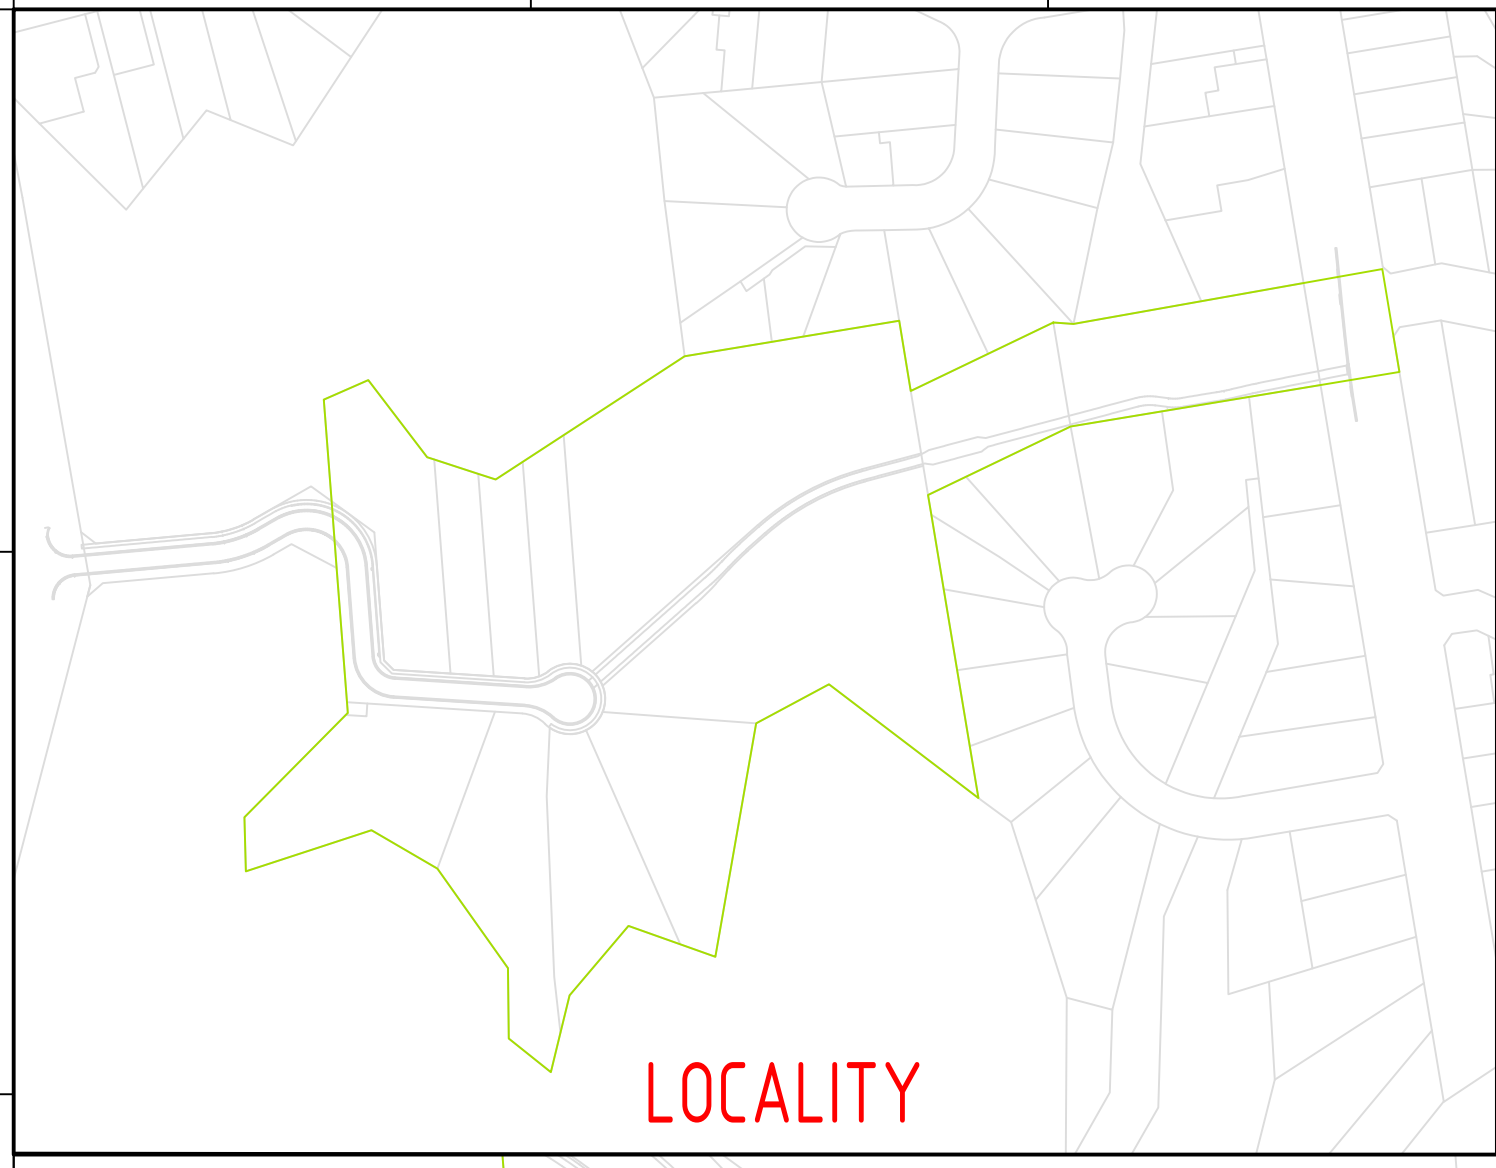

PROJECT LEGEND

	PIT-ID 2	Service Drop Access Pit (650mmX280mmX565mm)
	PIT-ID 5	Network Boundary/Local Network Pit (Single Lid) (700mmX450mmX650mm)
	PIT-ID 6	Distribution/Local Network Connection Pit (Dual Lid) (1360mmX555mmX650mm)
	PIT-ID 8	Distribution/Local Network Connection Pit (1360mmX555mmX860mm)
	PIT-ID 9	Fibre Distribution Hub (FDH) Pit (2000mmX555mmX900mm)
	PWR	Transformer / Kiosk / Pad Mount Sub-station / Pole Mount Transformer
	(S)	Existing Telstra Pit (2,3,4,5,6,7,8,9)

SDU Development Information

Development Name:	Hidden Court
Developer Company:	Agarius Pty Ltd
Development Address:	169 Edwards Road, Kennington
Authorised Rep:	Tom Davies - Terraco
Phone:	0432 948 731
E-Mail:	tdavies@terraco.com.au
nbn Reference Number:	STG-W000197497
Stage Number:	1 of 1
Design Revision:	C

BILL OF MATERIAL

NO OF LOTS: 10


PITS		DUCTS	
SIZE	QTY	SIZE	QTY MTRS
2	2	P100	4 390.9
5	4	P50	2 69.4
6	0	P20	10 143.3
8	0		
9	0		

TOTAL NUMBER OF PITS: 6
 TOTAL NUMBER OF MANHOLES: 0
 TOTAL NUMBER OF CONDUITS: 16
 TOTAL LENGTH OF CONDUITS: 601.6

WARNING

BEWARE OF UNDERGROUND SERVICES

THE LOCATION OF UNDERGROUND SERVICES ARE APPROXIMATE ONLY AND THEIR EXACT POSITION SHOULD BE PROVEN ON SITE. NO GUARANTEE IS GIVEN THAT ALL EXISTING SERVICES ARE SHOWN.

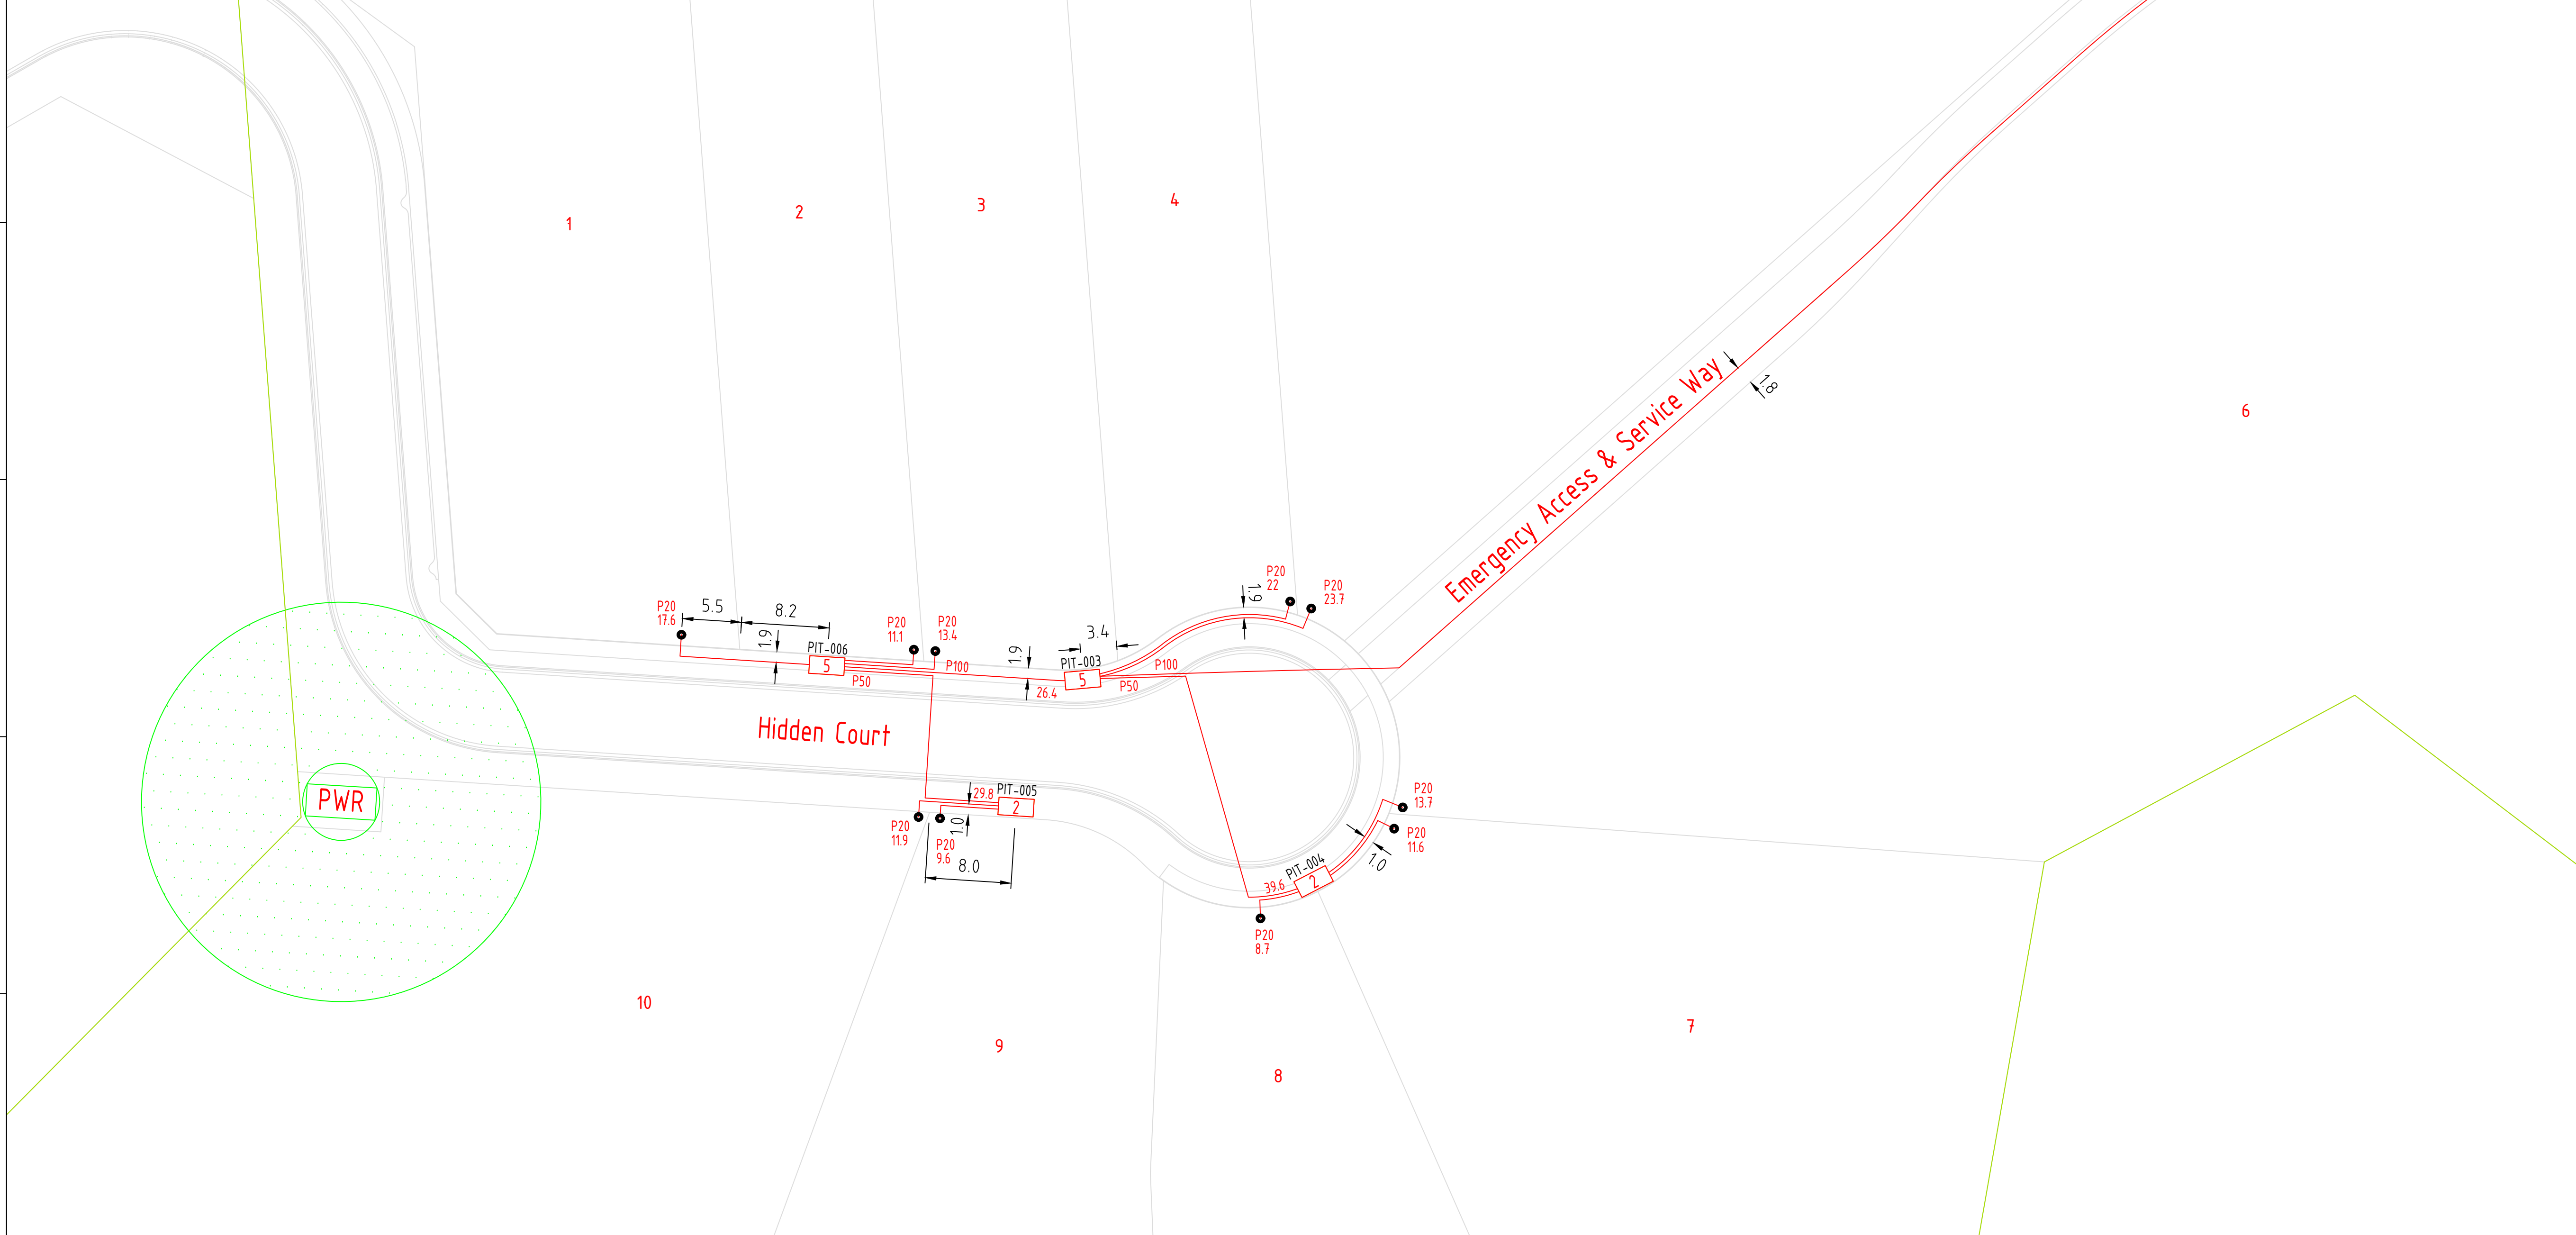

REV	DATE	DRAFTER	DESCRIPTION	APPROVED
C	06/10/2023	TD (TERRACO)	AS BUILT	AS (TERRACO)
B	19/06/2023	JS (TERRACO)	REVISED NBN OFFSET IN HIDDEN COURT	DR (TERRACO)
A	13/02/2023	JS (TERRACO)	INITIAL DESIGN	DR (TERRACO)

STRICTLY CONFIDENTIAL

NBNC APPROVAL RECORD:

SIGNATURE	DATE
<input type="checkbox"/> DD	_____
<input type="checkbox"/> WD	_____
<input type="checkbox"/> AB	_____

QUALITY RECORD :

NBNC DISCLAIMER
 THIS DOCUMENT HAS BEEN PREPARED SOLELY FOR THE USE OF NBNC LIMITED (ABN 86 136 533 741) FOR USE IN MAINTAINING NBNC FACILITIES. IT HAS NOT BEEN CREATED FOR ANY OTHER USE. IT SHOULD NOT BE SCALED TO LOCATE NBNC ASSETS. NO WARRANTY IS GIVEN THAT THE INFORMATION IS ACCURATE OR COMPLETE.

Terraco P/L
 ABN 12 681 695 776
 9 Jewell Court
 East Bendigo, Vic 3550
 Ph: 03 5442 5799
 Fax: 03 5441 5506
 E: info@terraco.com.au
 Web: www.terraco.com.au

KEY PLAN

DRAWING TITLE:
 NBN PIT & PIPE DESIGN
 HIDDEN COURT
 KENNINGTON
 10 LOTS

ENABLE#: 414213

STATE: VIC REGION:

FSA: SAM: ADA:

PROJECT No: STG-W000197497

CADREF No: 09075

SCALE: N/A SHEET No. 2 OF 2 REV. C