
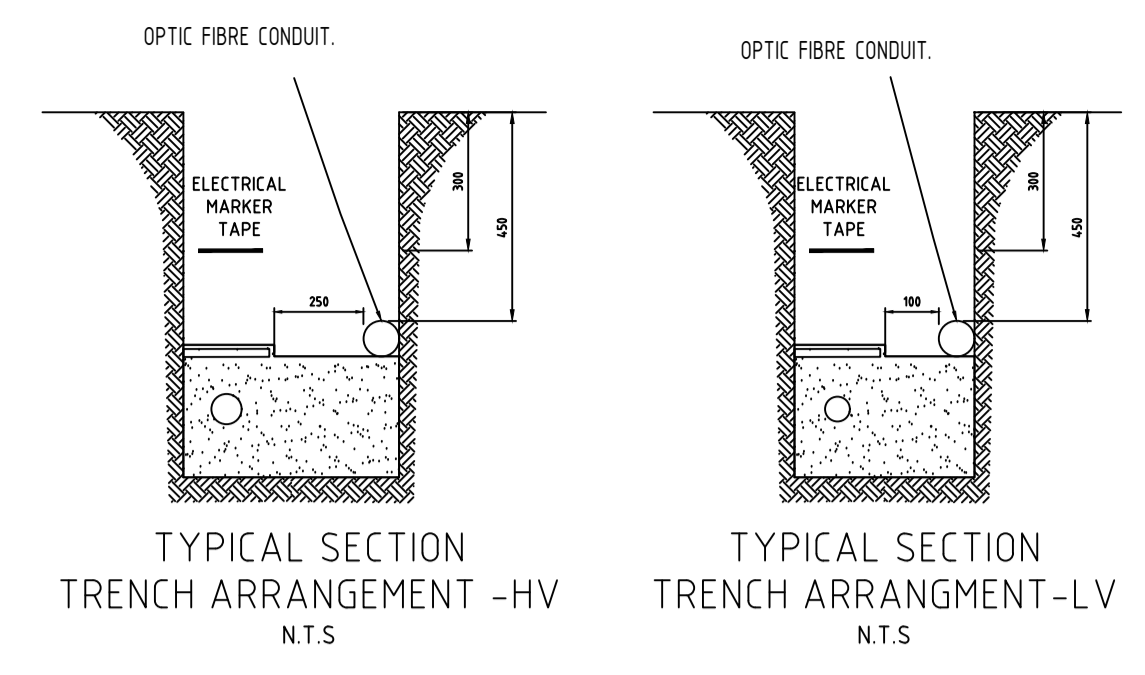


AS BUILT

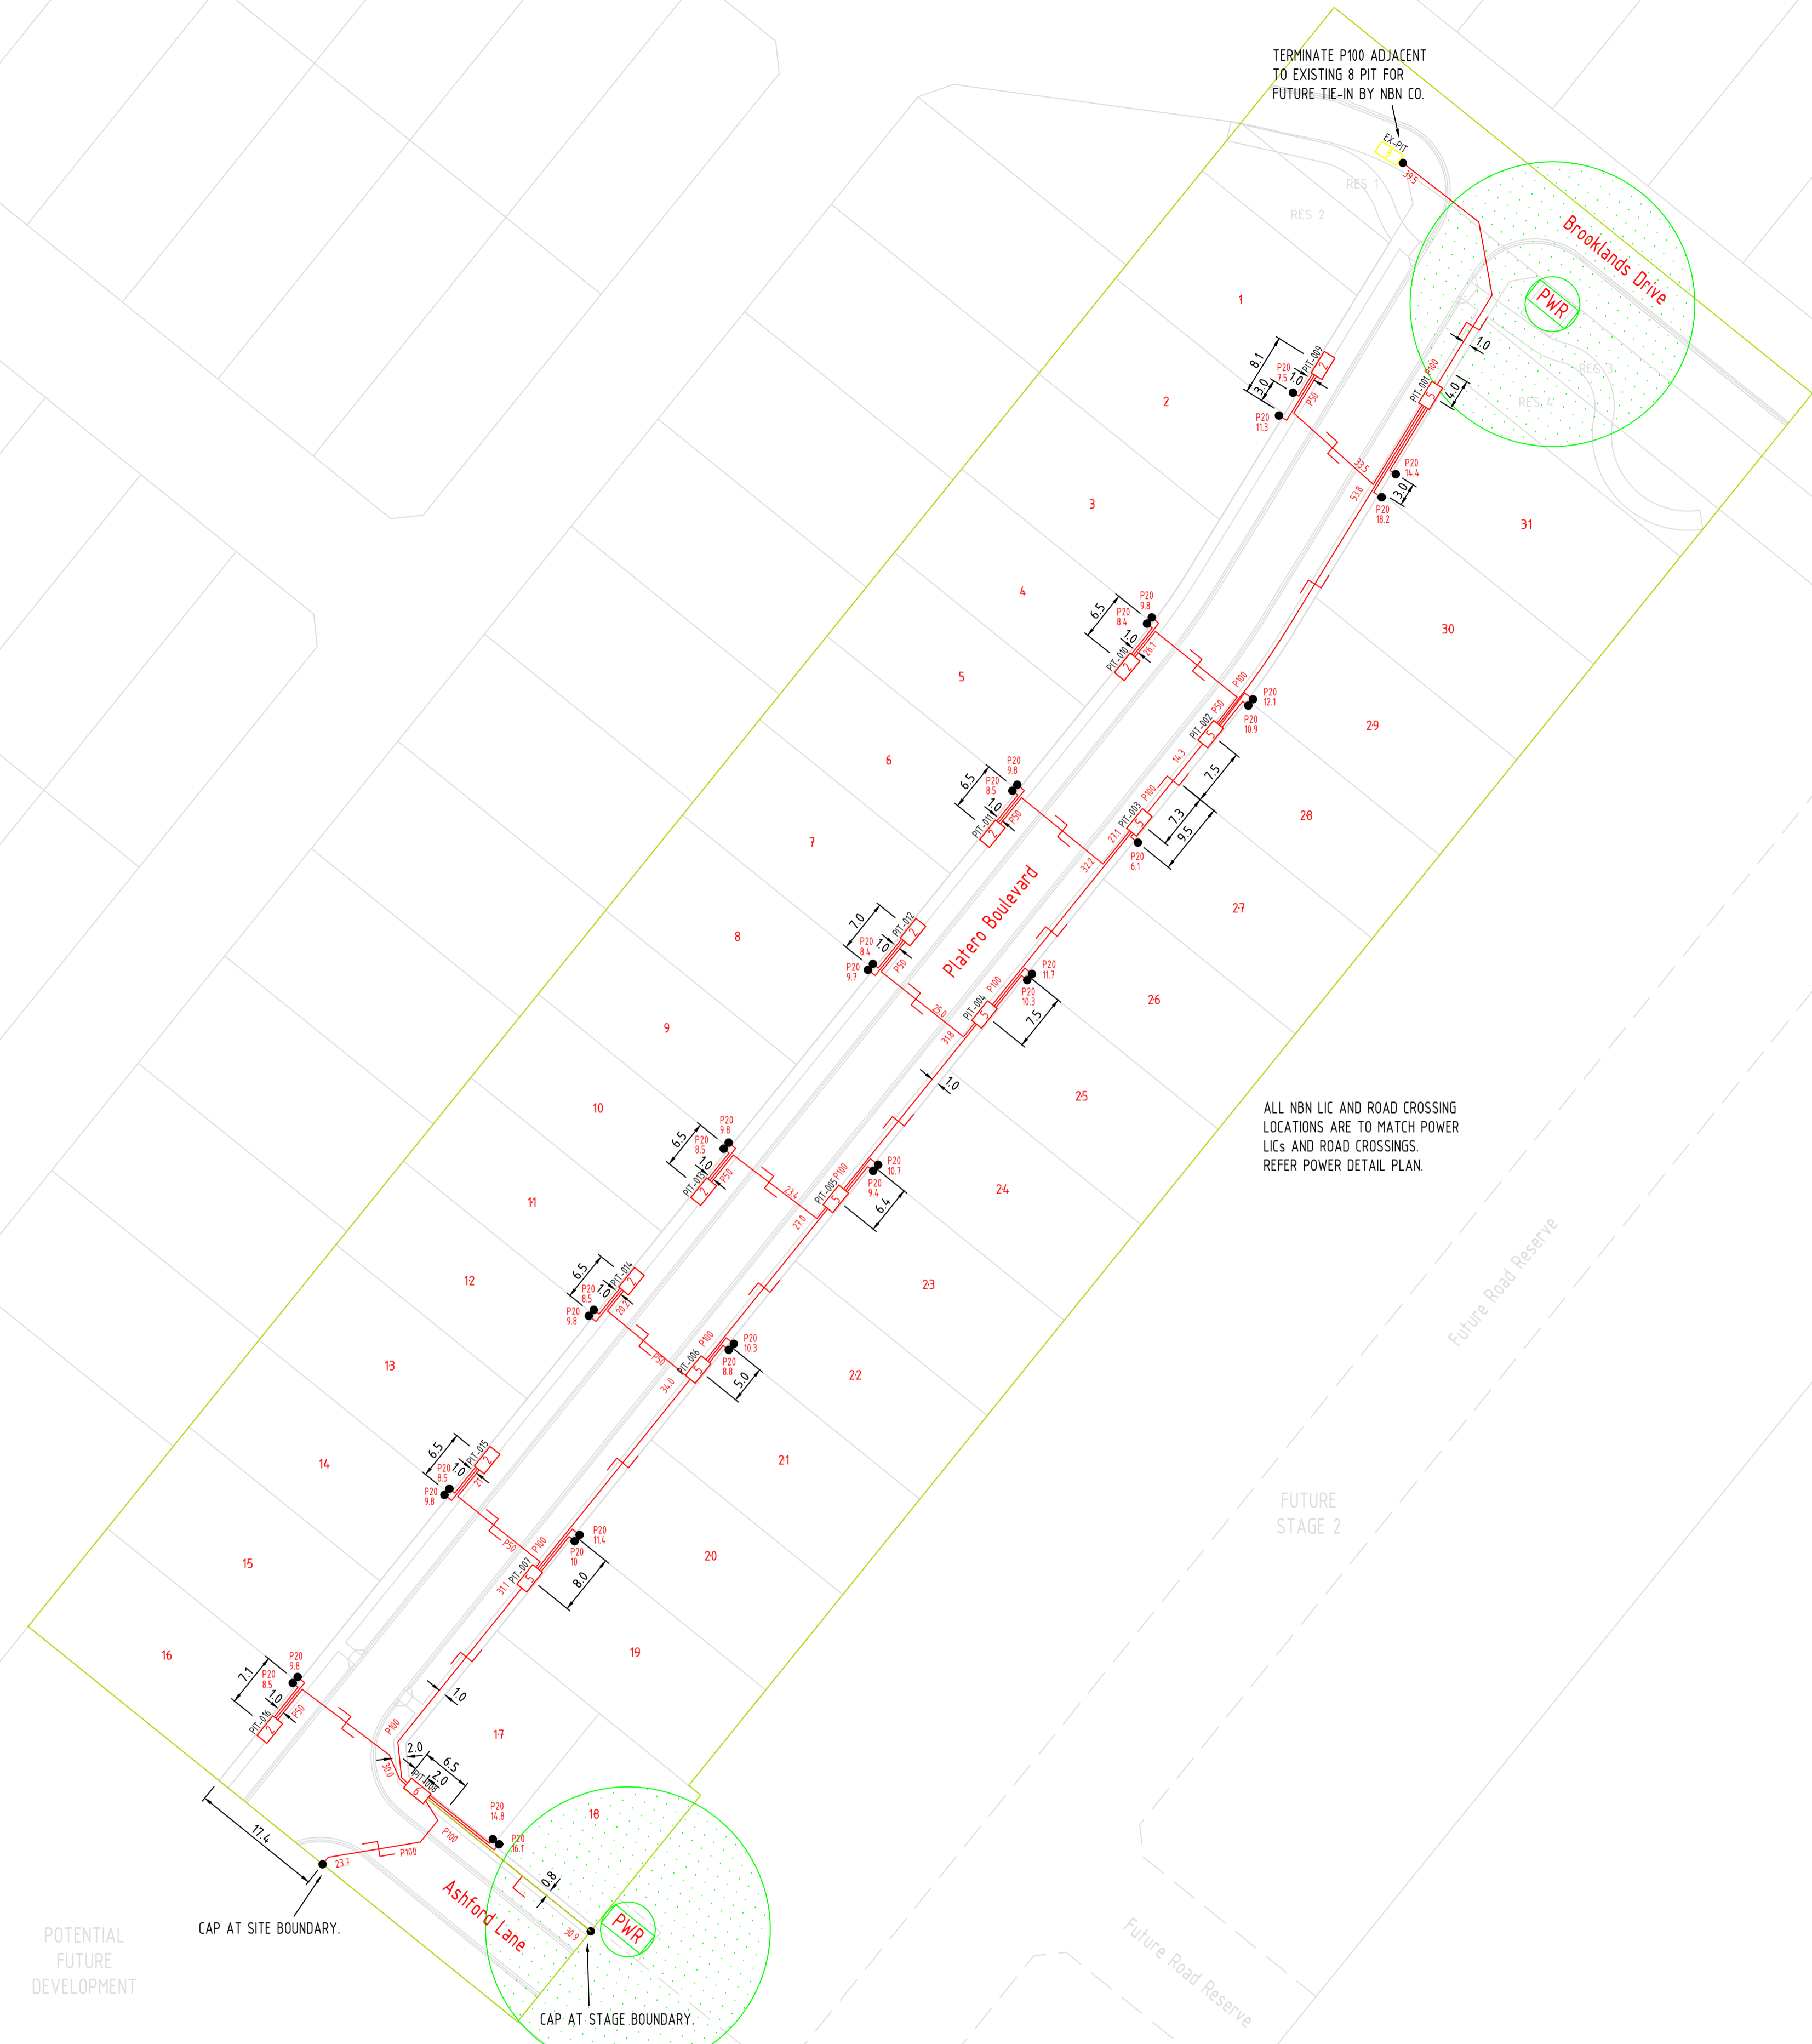

PROJECT LEGEND

PIT-ID	Service Drop Access Pit (650mmX280mmX565mm)
PIT-ID	Network Boundary/Local Network Pit (Single Lid) (700mmX450mmX650mm)
PIT-ID	Distribution/Local Network Connection Pit (Dual Lid) (1360mmX555mmX650mm)
PIT-ID	Distribution/Local Network Connection Pit (1360mmX555mmX860mm)
PIT-ID	Fibre Distribution Hub (FDH) Pit (2000mmX555mmX900mm)
PWR	Transformer / Kiosk / Pad Mount Sub-station / Pole Mount Transformer
Ⓢ	Existing Telstra Pit (2,3,4,5,6,7,8,9)

SDU Development Information

Development Name:
Bartels Run - Stage One

Developer Company:
Arbor Estates Pty Ltd

Development Address:
6 Brooklands Drive, Jackass Flat

Authorised Rep:
Jordan Sens
Phone: 0432 948 731
E-Mail: tdavies@terraco.com.au

nbn Reference Number: STG-M000141491

Stage Number: 1

Design Revision: C

BILL OF MATERIAL

NO OF LOTS: 31

PITS		DUCTS	
SIZE	QTY	SIZE	QTY MTRS
2	8	P100	10 322.7
5	7	P50	8 202.3
6	1	P20	31 321.8
8	0		
9	0		

TOTAL NUMBER OF PITS: 16
 TOTAL NUMBER OF MANHOLES: 0
 TOTAL NUMBER OF CONDUITS: 49
 TOTAL LENGTH OF CONDUITS: 846.8

WARNING

BEWARE OF UNDERGROUND SERVICES

THE LOCATION OF UNDERGROUND SERVICES ARE APPROXIMATE ONLY AND THEIR EXACT POSITION SHOULD BE PROVEN ON SITE. NO GUARANTEE IS GIVEN THAT ALL EXISTING SERVICES ARE SHOWN.

REV	DATE	DRAFTER	DESCRIPTION	APPROVED
C	24/04/2024	TD (TERRACO)	AS BUILT	AS (TERRACO)
B	19/01/2024	JS (TERRACO)	CONSTRUCTION ISSUE	DR (TERRACO)
A	29/07/2023	JS (TERRACO)	INITIAL DESIGN	DR (TERRACO)

STRICTLY CONFIDENTIAL

NBNCO APPROVAL RECORD:

<input type="checkbox"/> DD	SIGNATURE	DATE
<input type="checkbox"/> WD		
<input type="checkbox"/> AB		

QUALITY RECORD :

NBNCO DISCLAIMER
 THIS DOCUMENT HAS BEEN PREPARED SOLELY FOR THE USE OF NBNCO LIMITED (ABN 86 136 533 741) FOR USE IN MAINTAINING NBNCO FACILITIES. IT HAS NOT BEEN CREATED FOR ANY OTHER USE. IT SHOULD NOT BE SCALED TO LOCATE NBNCO ASSETS. NO WARRANTY IS GIVEN THAT THE INFORMATION IS ACCURATE OR COMPLETE.

Australia's broadband network

TERRACO
 Civil Engineers
 Project Managers
 Development Consultants

Terraco P/L
 ABN 12 681 695 776
 9 Jewell Court
 East Bendigo, Vic 3550
 Ph: 03 5442 5799
 Fax: 03 5441 5506
 E: info@terraco.com.au
 Web: www.terraco.com.au

KEY PLAN

DRAWING TITLE:
 NBN PIT & PIPE DESIGN
 BARTELS RUN - STAGE ONE
 JACKASS FLAT
 31 LOTS

ENABLE#: 414213

STATE: VIC REGION:

FSA: SAM: ADA:

PROJECT No: STG-M000141491

CADREF No: 23005

SCALE: N/A SHEET No. 1 OF 1 REV. C

